


SITE PLAN, SCALE 1:100

ground floor plan 1:50

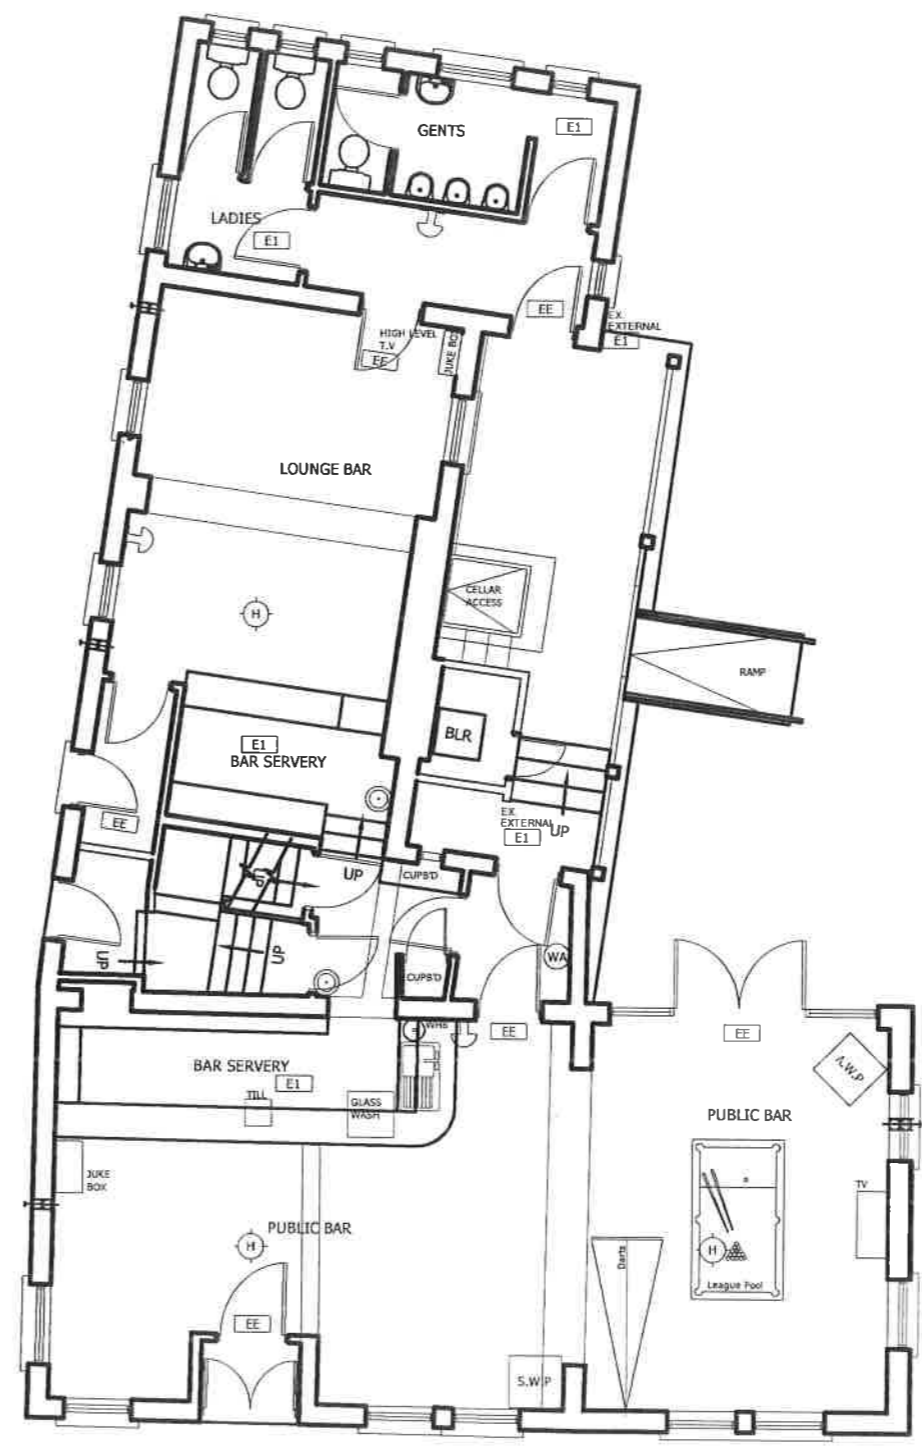


CONTRACTORS PLEASE NOTE
 No dimensions to be scaled from this drawing. Contractors are to check all sizes & dimensions before setting out or shopwork.
 Any errors & discrepancies to be reported to the designer. This drawing is the property of BDC Designs Ltd & must not be reproduced without the permission of the Company.

rev	date	revision

KEY

N1	General Fire Notice
N2	Staff Fire Notice
N3	'Fire Door Keep Locked' sign
N4	'Fire Exit Keep Clear' sign
FB	Fire Blanket
FE	Fire Extinguisher
E1	Emergency Light Fitting
EE	Emergency Exit Sign
H	Heat Detector
S	Smoke Detector
C	Break Glass Call Point
SA	Fire Alarm Sounder
FAP	Fire Alarm Panel
AWP	Amusement with Prizes
SWP	Skill with Prizes
ATM	Cash machines
PP	Pay Phone

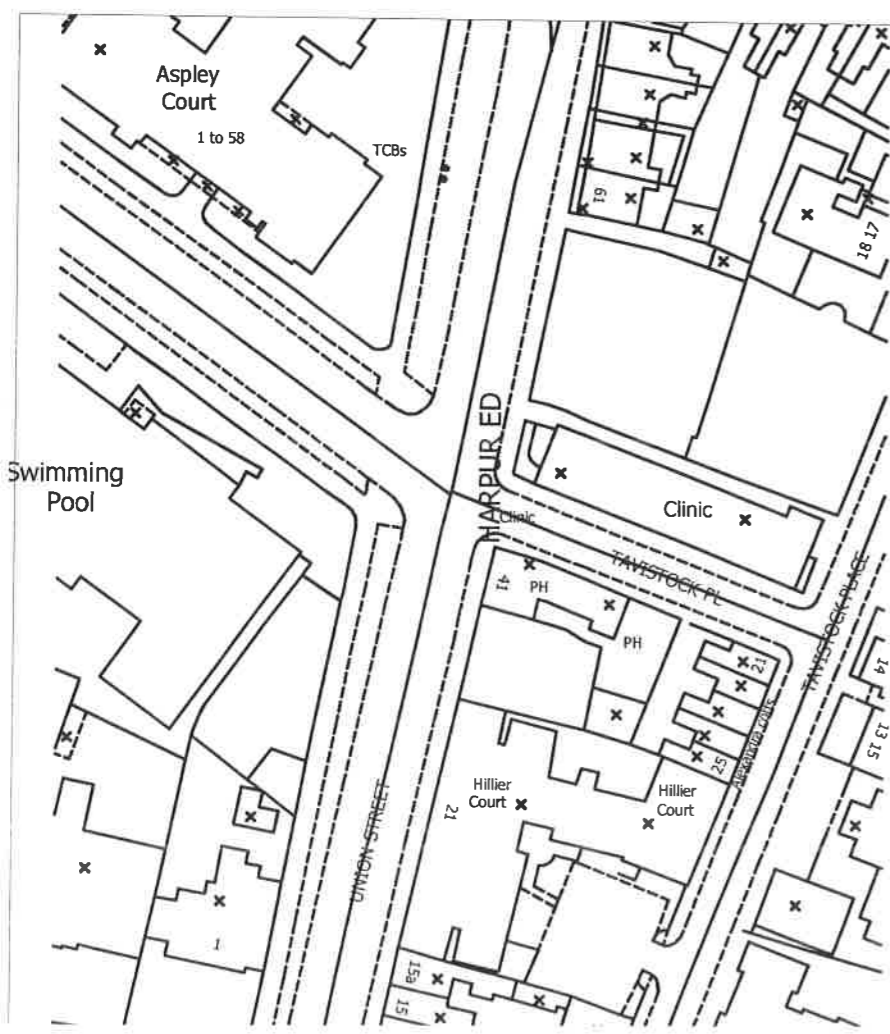

Location plan 1:500

bdc designs, The Stables, 15 Massey Brook Lane, Lymington, Hampshire SO41 3PH, England
 t +44 (0)1703 74 73 07 fax +44 (0)1703 74 73 07
 e info@bdcdesigns.com www.bdcdesigns.com

AS BUILT GROUND FLOOR & SITE PLANS

job
**FORRESTER'S ARMS
 UNION STREET
 BEDFORD**

client
**CHARLES WELLS
 (THE EAGLE BREWERY)**

date
APRIL 2006

drawing no